


REGISTERED SURVEYOR'S CERTIFICATION

I, PAUL S. REED, hereby certify that the vertical and horizontal locations and dimensions shown on this plan are a true and correct record and were located by survey.

Registered Surveyor (sig.) Reg. Surveyor No. 1427 Date: 15/01/2021

AS CONSTRUCTED

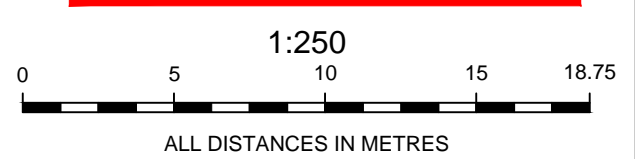

A1	1	15/01/2021	ORIGINAL ISSUE	QSD	PSR	PSR
	INDEX	DATE	REVISIONS	DRAWN	CHECKED	PASSED

DRAWN	QSD	15/01/2021
CHECKED	PSR	15/01/2021
PASSED	PSR	15/01/2021
INITIALS	DATE	



Queensland Urban Utilities

72 ACACIA ROAD, KARAWATHA STAGE 1
AS CONSTRUCTED SEWER

SCALE	1:250
SHEET 1 OF 2 SHEETS	
DRAWING NO.	4639-1-SEW
	1




REGISTERED SURVEYOR'S CERTIFICATION

I, PAUL S. REED, hereby certify that the vertical and horizontal locations and dimensions shown on this plan are a true and correct record and were located by survey.

Registered Surveyor (Sig.) Reg. Surveyor No. 1427 Date: 15/01/2021

AS CONSTRUCTED

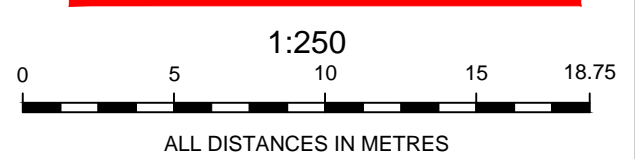

A1	1	15/01/2021	ORIGINAL ISSUE	QSD	PSR	PSR
	INDEX	DATE	REVISIONS	DRAWN	CHECKED	PASSED

DRAWN	QSD	15/01/2021
CHECKED	PSR	15/01/2021
PASSED	PSR	15/01/2021
INITIALS	DATE	





Queensland Urban Utilities

72 ACACIA ROAD, KARAWATHA STAGE 1
AS CONSTRUCTED SEWER

SCALE	1:250
SHEET 2	OF 2 SHEETS
DRAWING NO.	4639-1-SEW



ACACIA

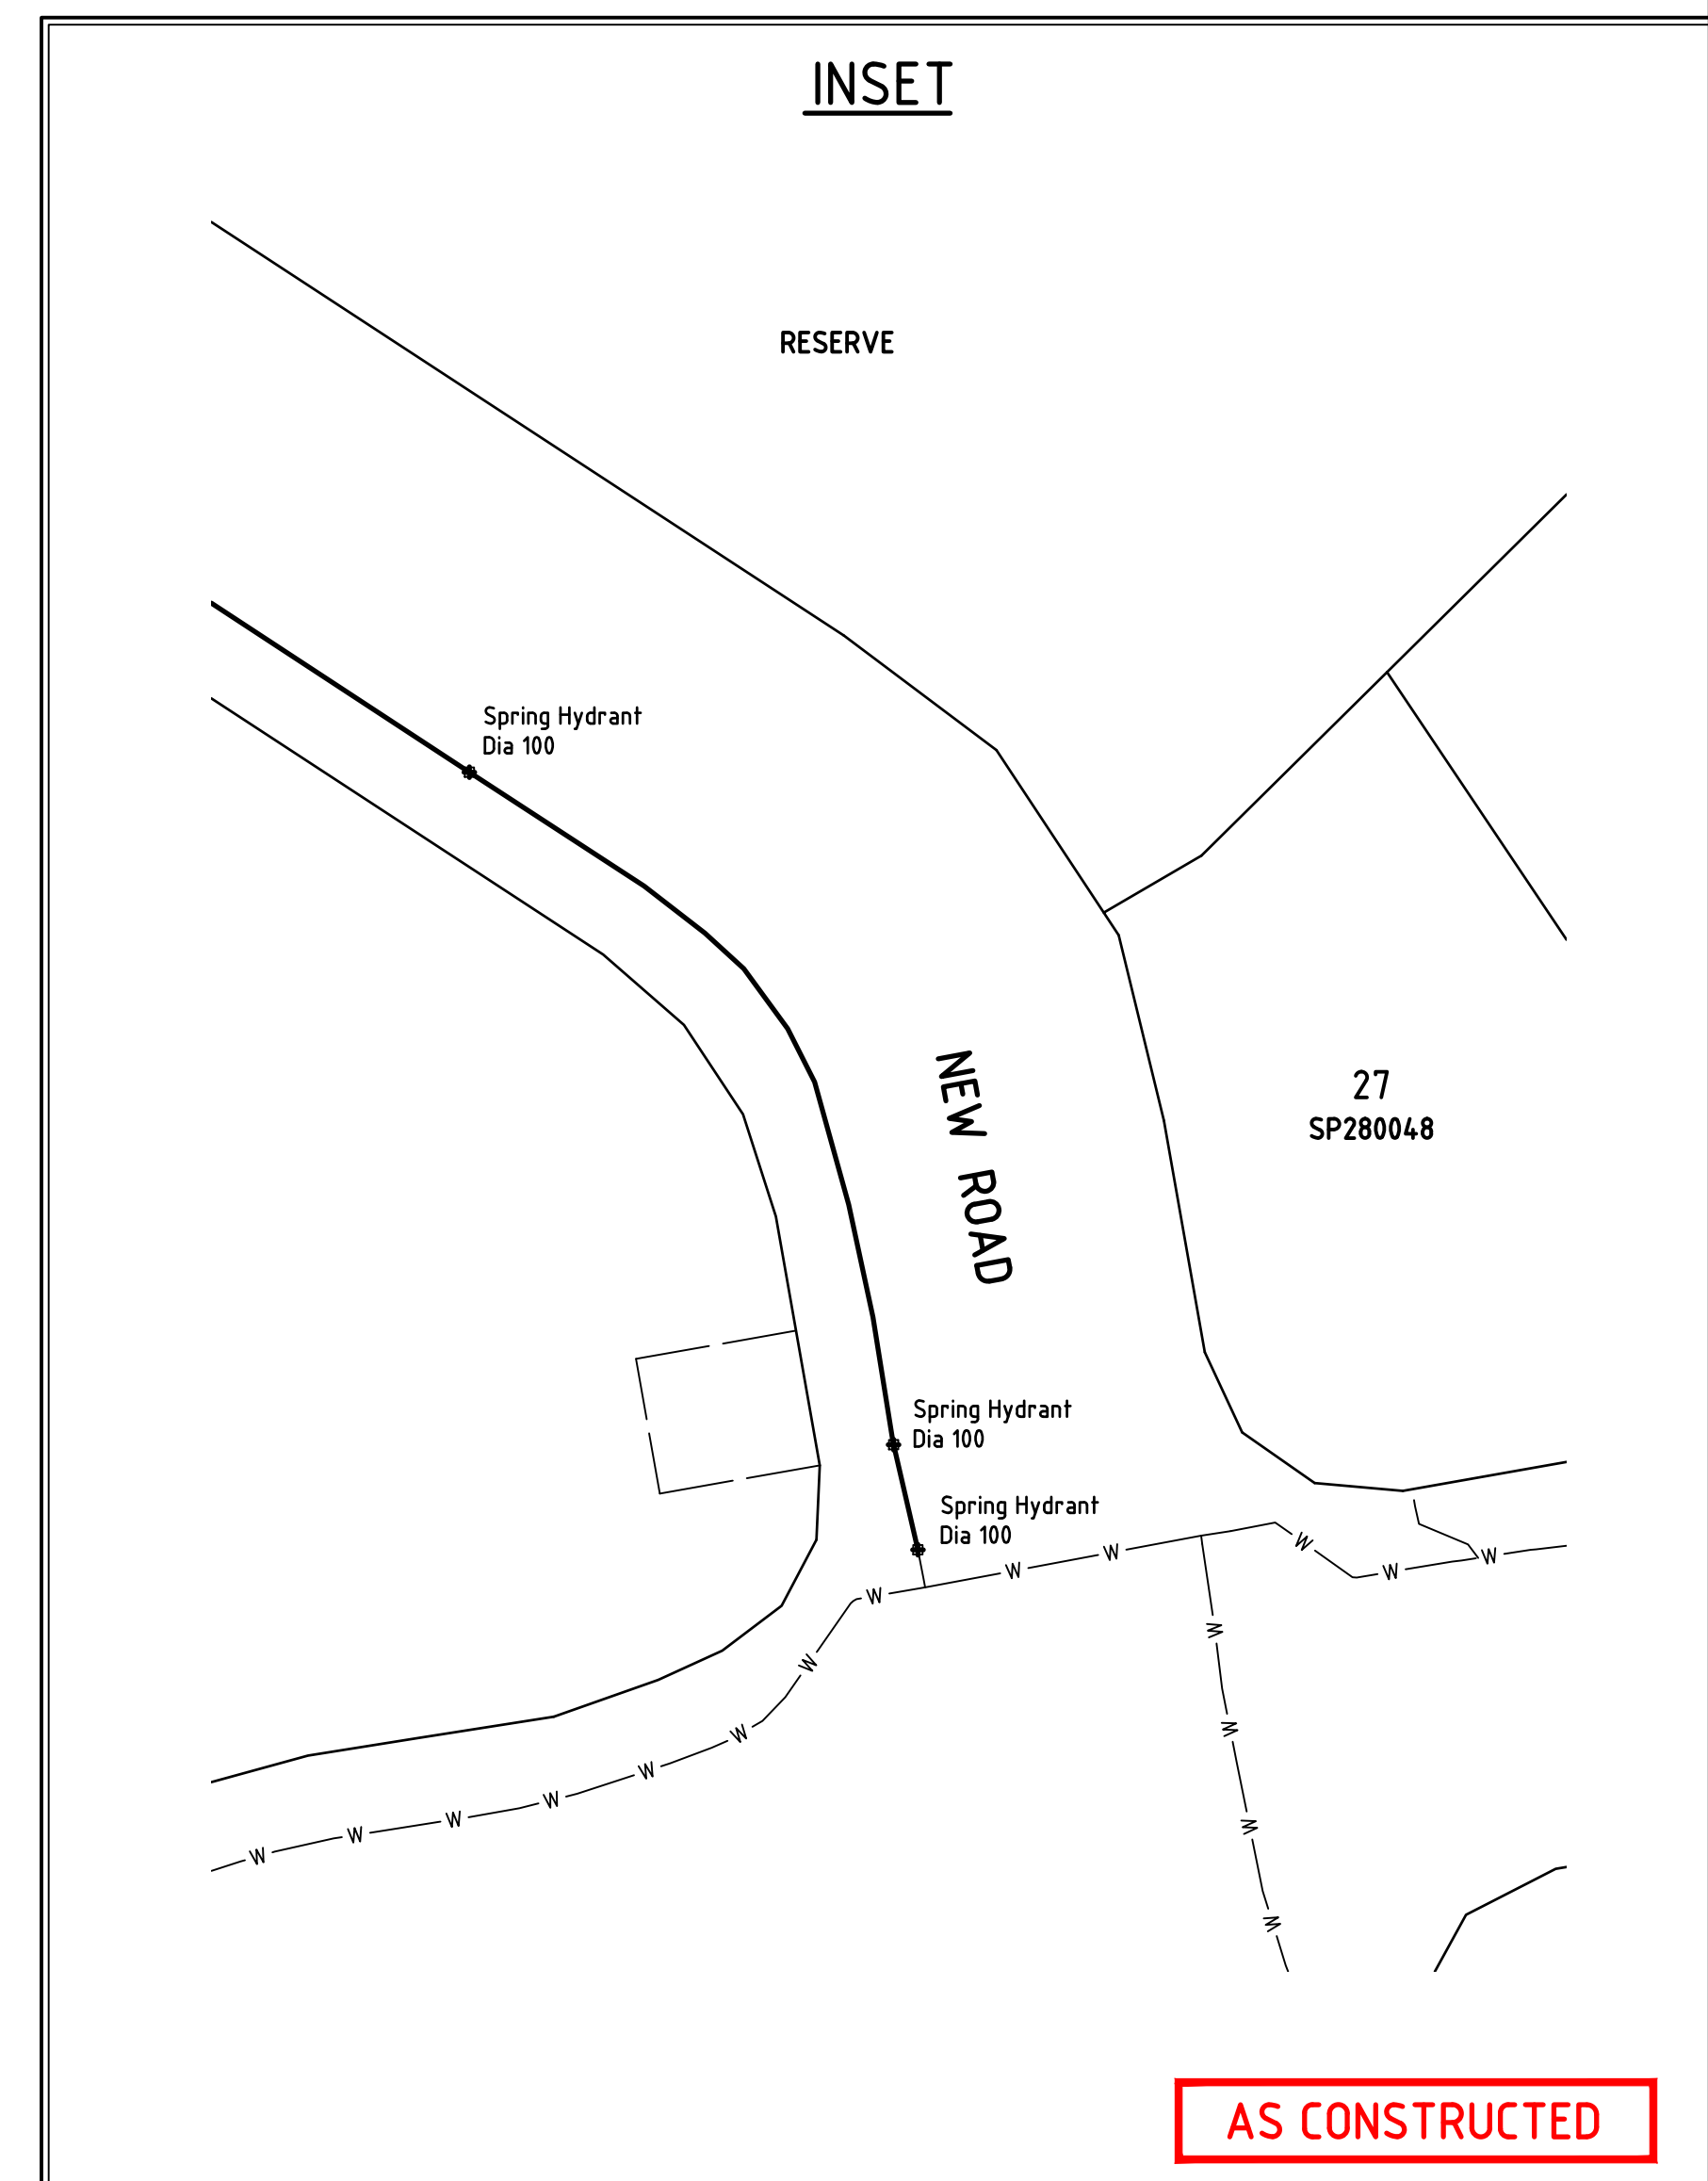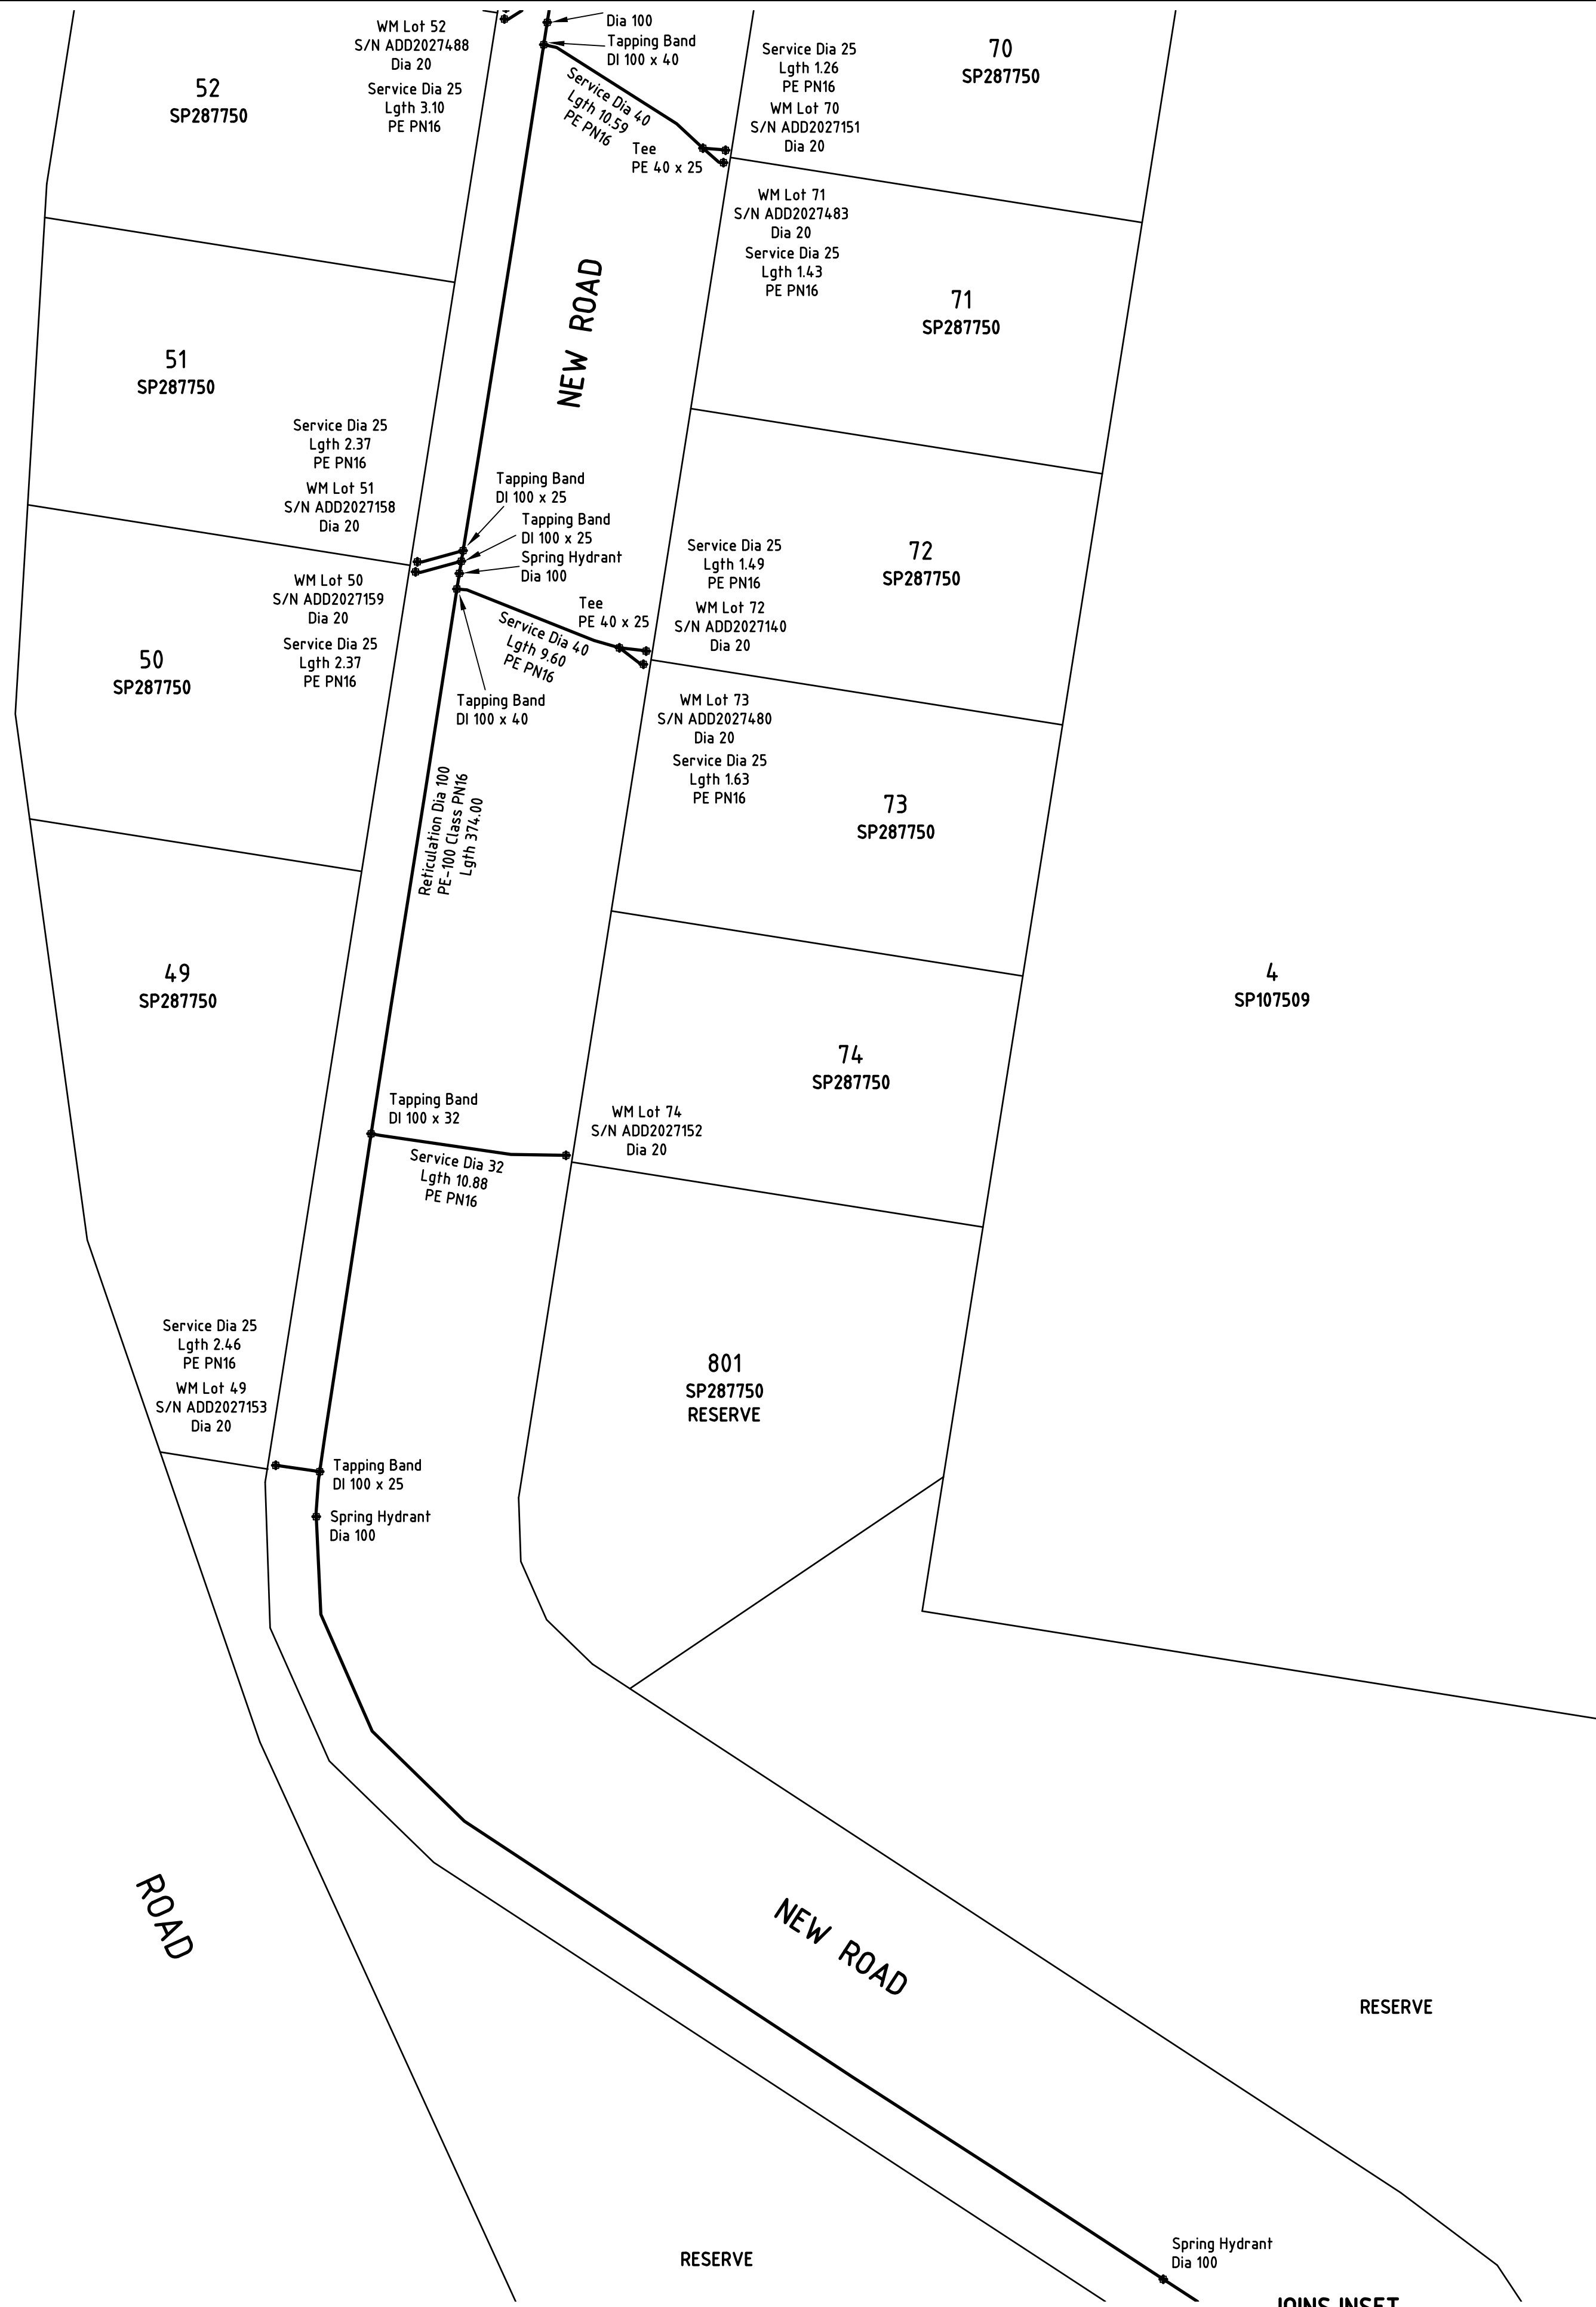

REGISTERED SURVEYOR'S CERTIFICATION
 I, PAUL S. REED, hereby certify that the vertical and horizontal locations and dimensions shown on this plan are a true and correct record and were located by survey.
 Registered Surveyor (sig.) Reg. Surveyor No. 1427 Date: 15/01/2021

AS CONSTRUCTED
 1:250
 ALL DISTANCES IN METRES


A1	1	15/01/2021	ORIGINAL ISSUE	QSD	PSR	PSR
	INDEX	DATE	REVISIONS	DRAWN	CHECKED	PASSED

DRAWN	QSD	15/01/2021
CHECKED	PSR	15/01/2021
PASSED	PSR	15/01/2021
INITIALS	DATE	



Queensland Urban Utilities
 72 ACACIA ROAD, KARAWATHA STAGE 1
 AS CONSTRUCTED WATER

SCALE	1:250
SHEET 1	OF 2 SHEETS
DRAWING NO.	4639-1-WAT

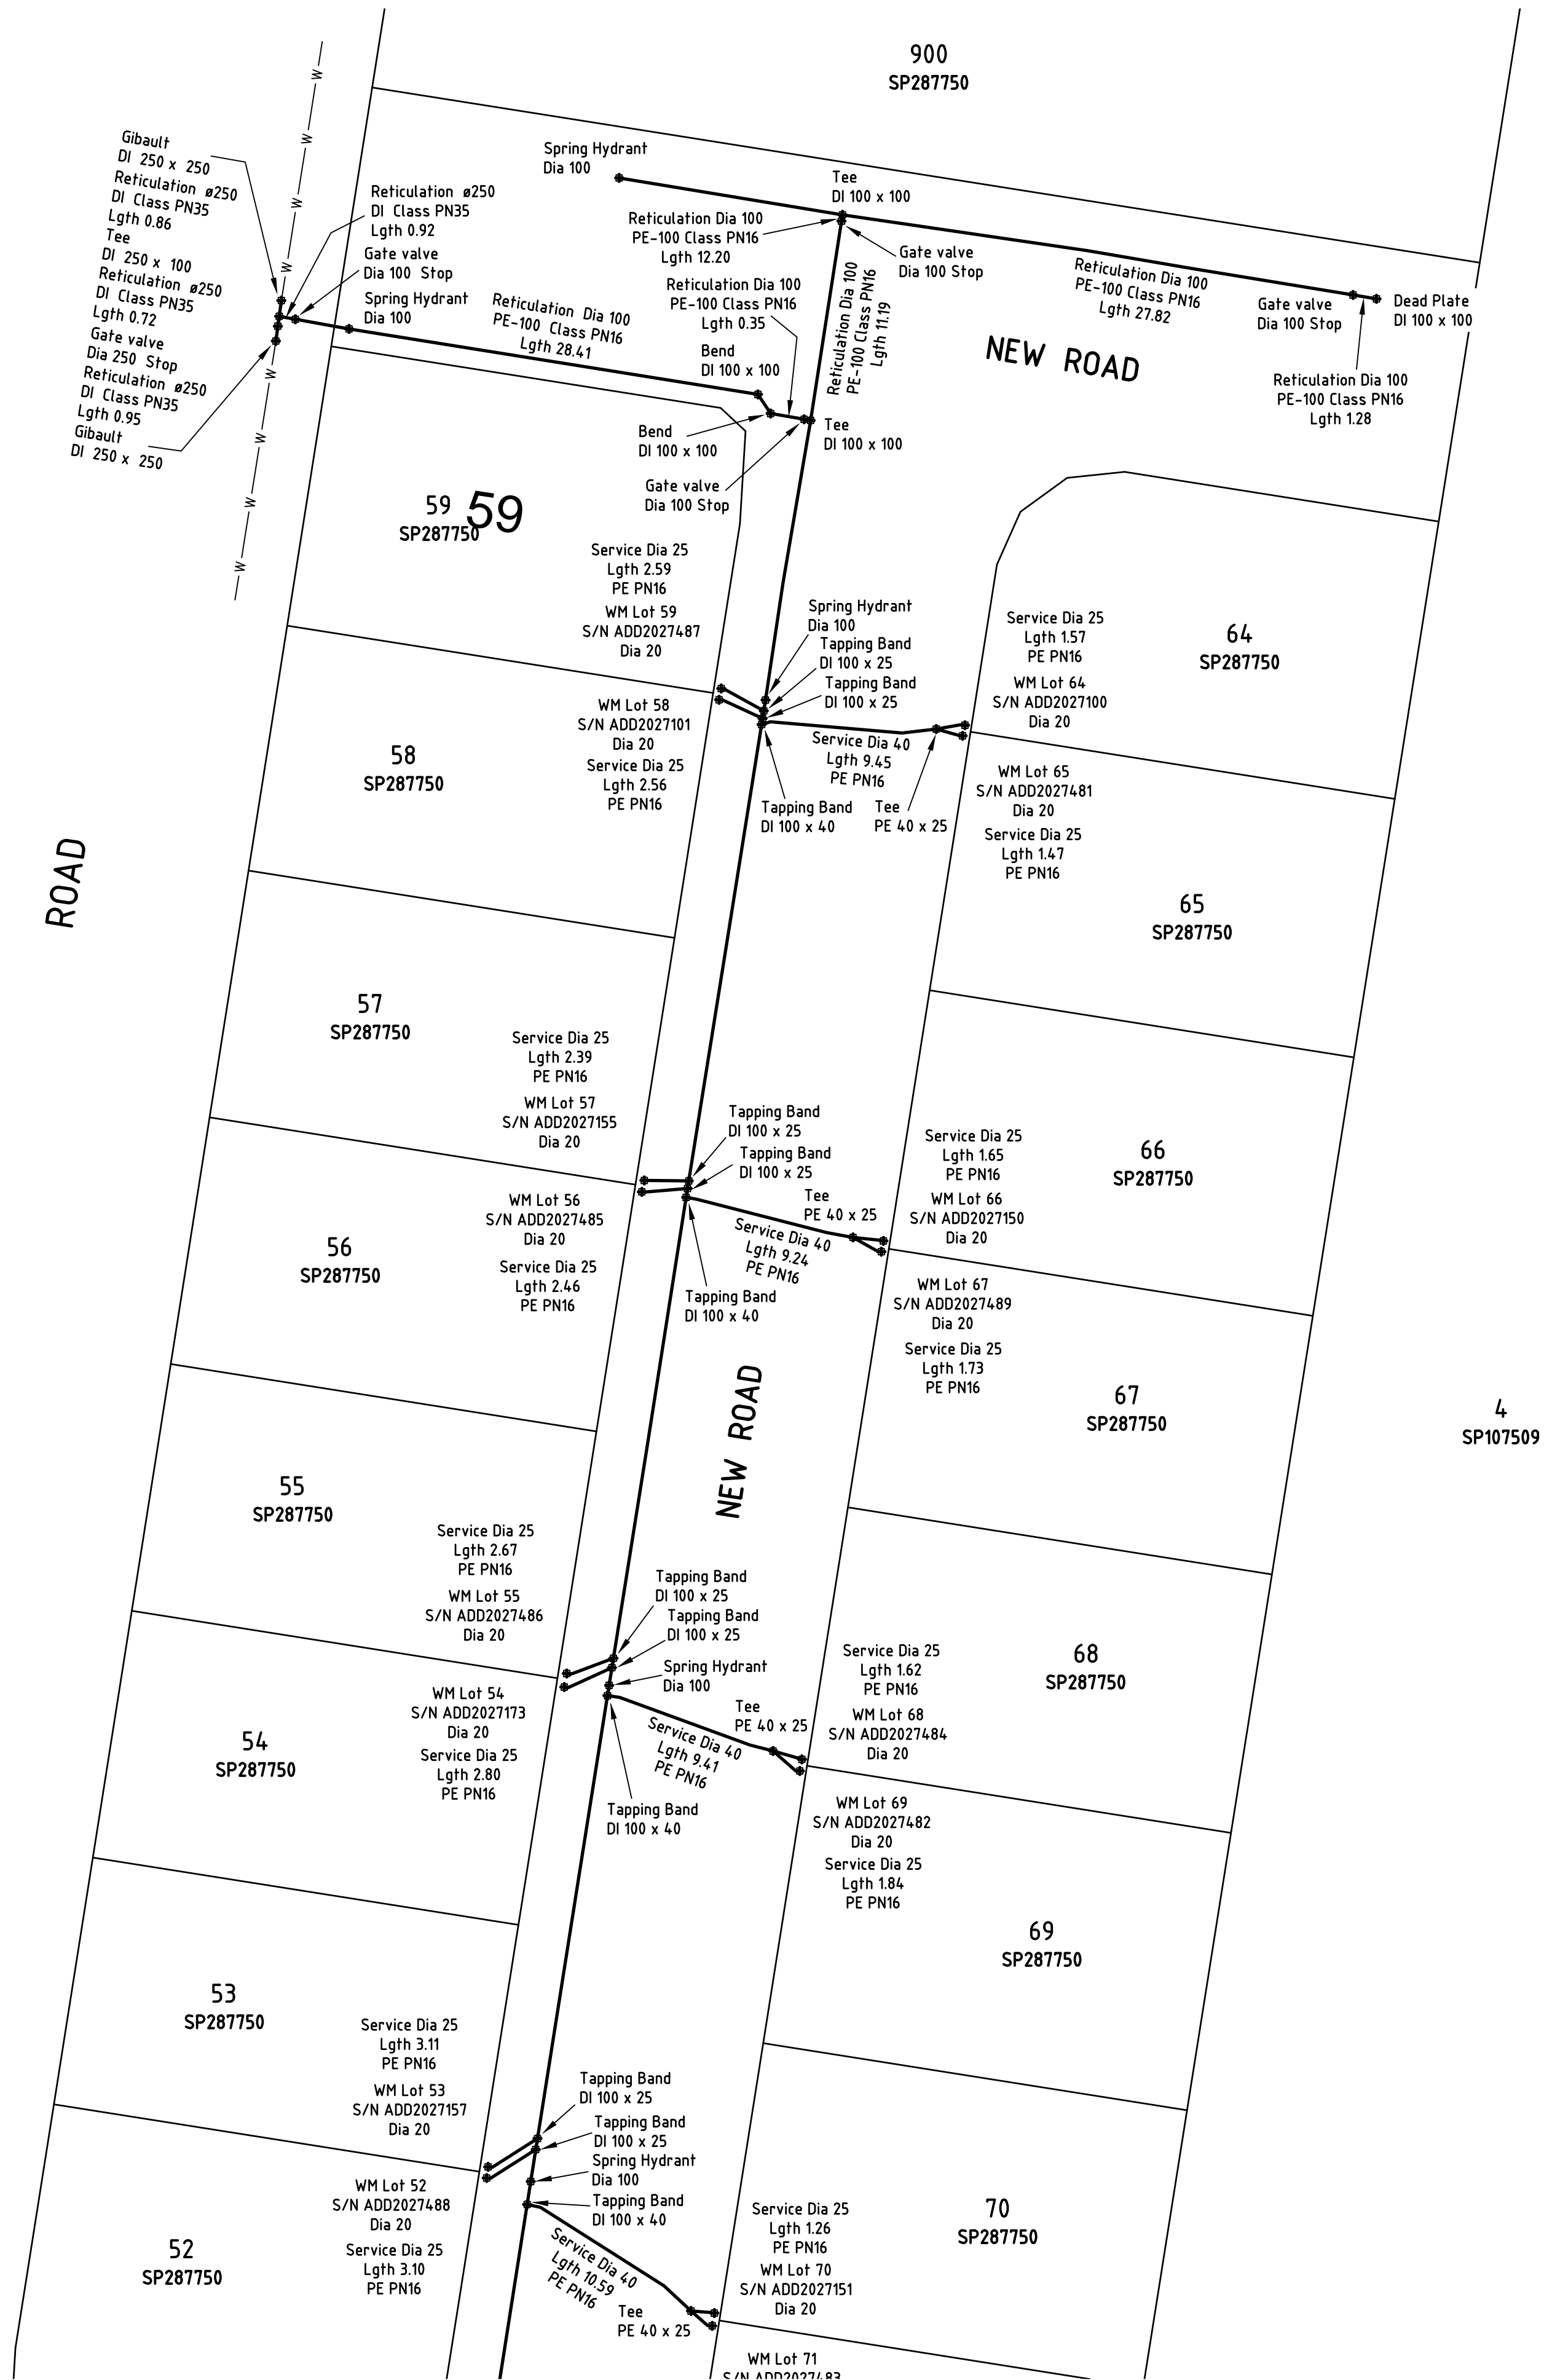


REGISTERED SURVEYOR'S CERTIFICATION

I, PAUL S. REED, hereby certify that the vertical and horizontal locations and dimensions shown on this plan are a true and correct record and were located by survey.

Registered Surveyor (sig.) Reg. Surveyor No. 1427 Date: 15/01/2021

AS CONSTRUCTED

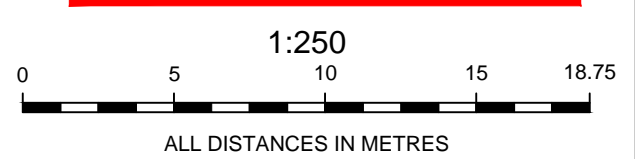

A1	1	15/01/2021	ORIGINAL ISSUE	QSD	PSR	PSR
	INDEX	DATE	REVISIONS	DRAWN	CHECKED	PASSED

DRAWN	QSD	15/01/2021
CHECKED	PSR	15/01/2021
PASSED	PSR	15/01/2021
INITIALS	DATE	



Queensland Urban Utilities

72 ACACIA ROAD, KARAWATHA STAGE 1
AS CONSTRUCTED WATER

SCALE	1:250
SHEET 2 OF 2 SHEETS	
DRAWING NO.	4639-1-WAT