


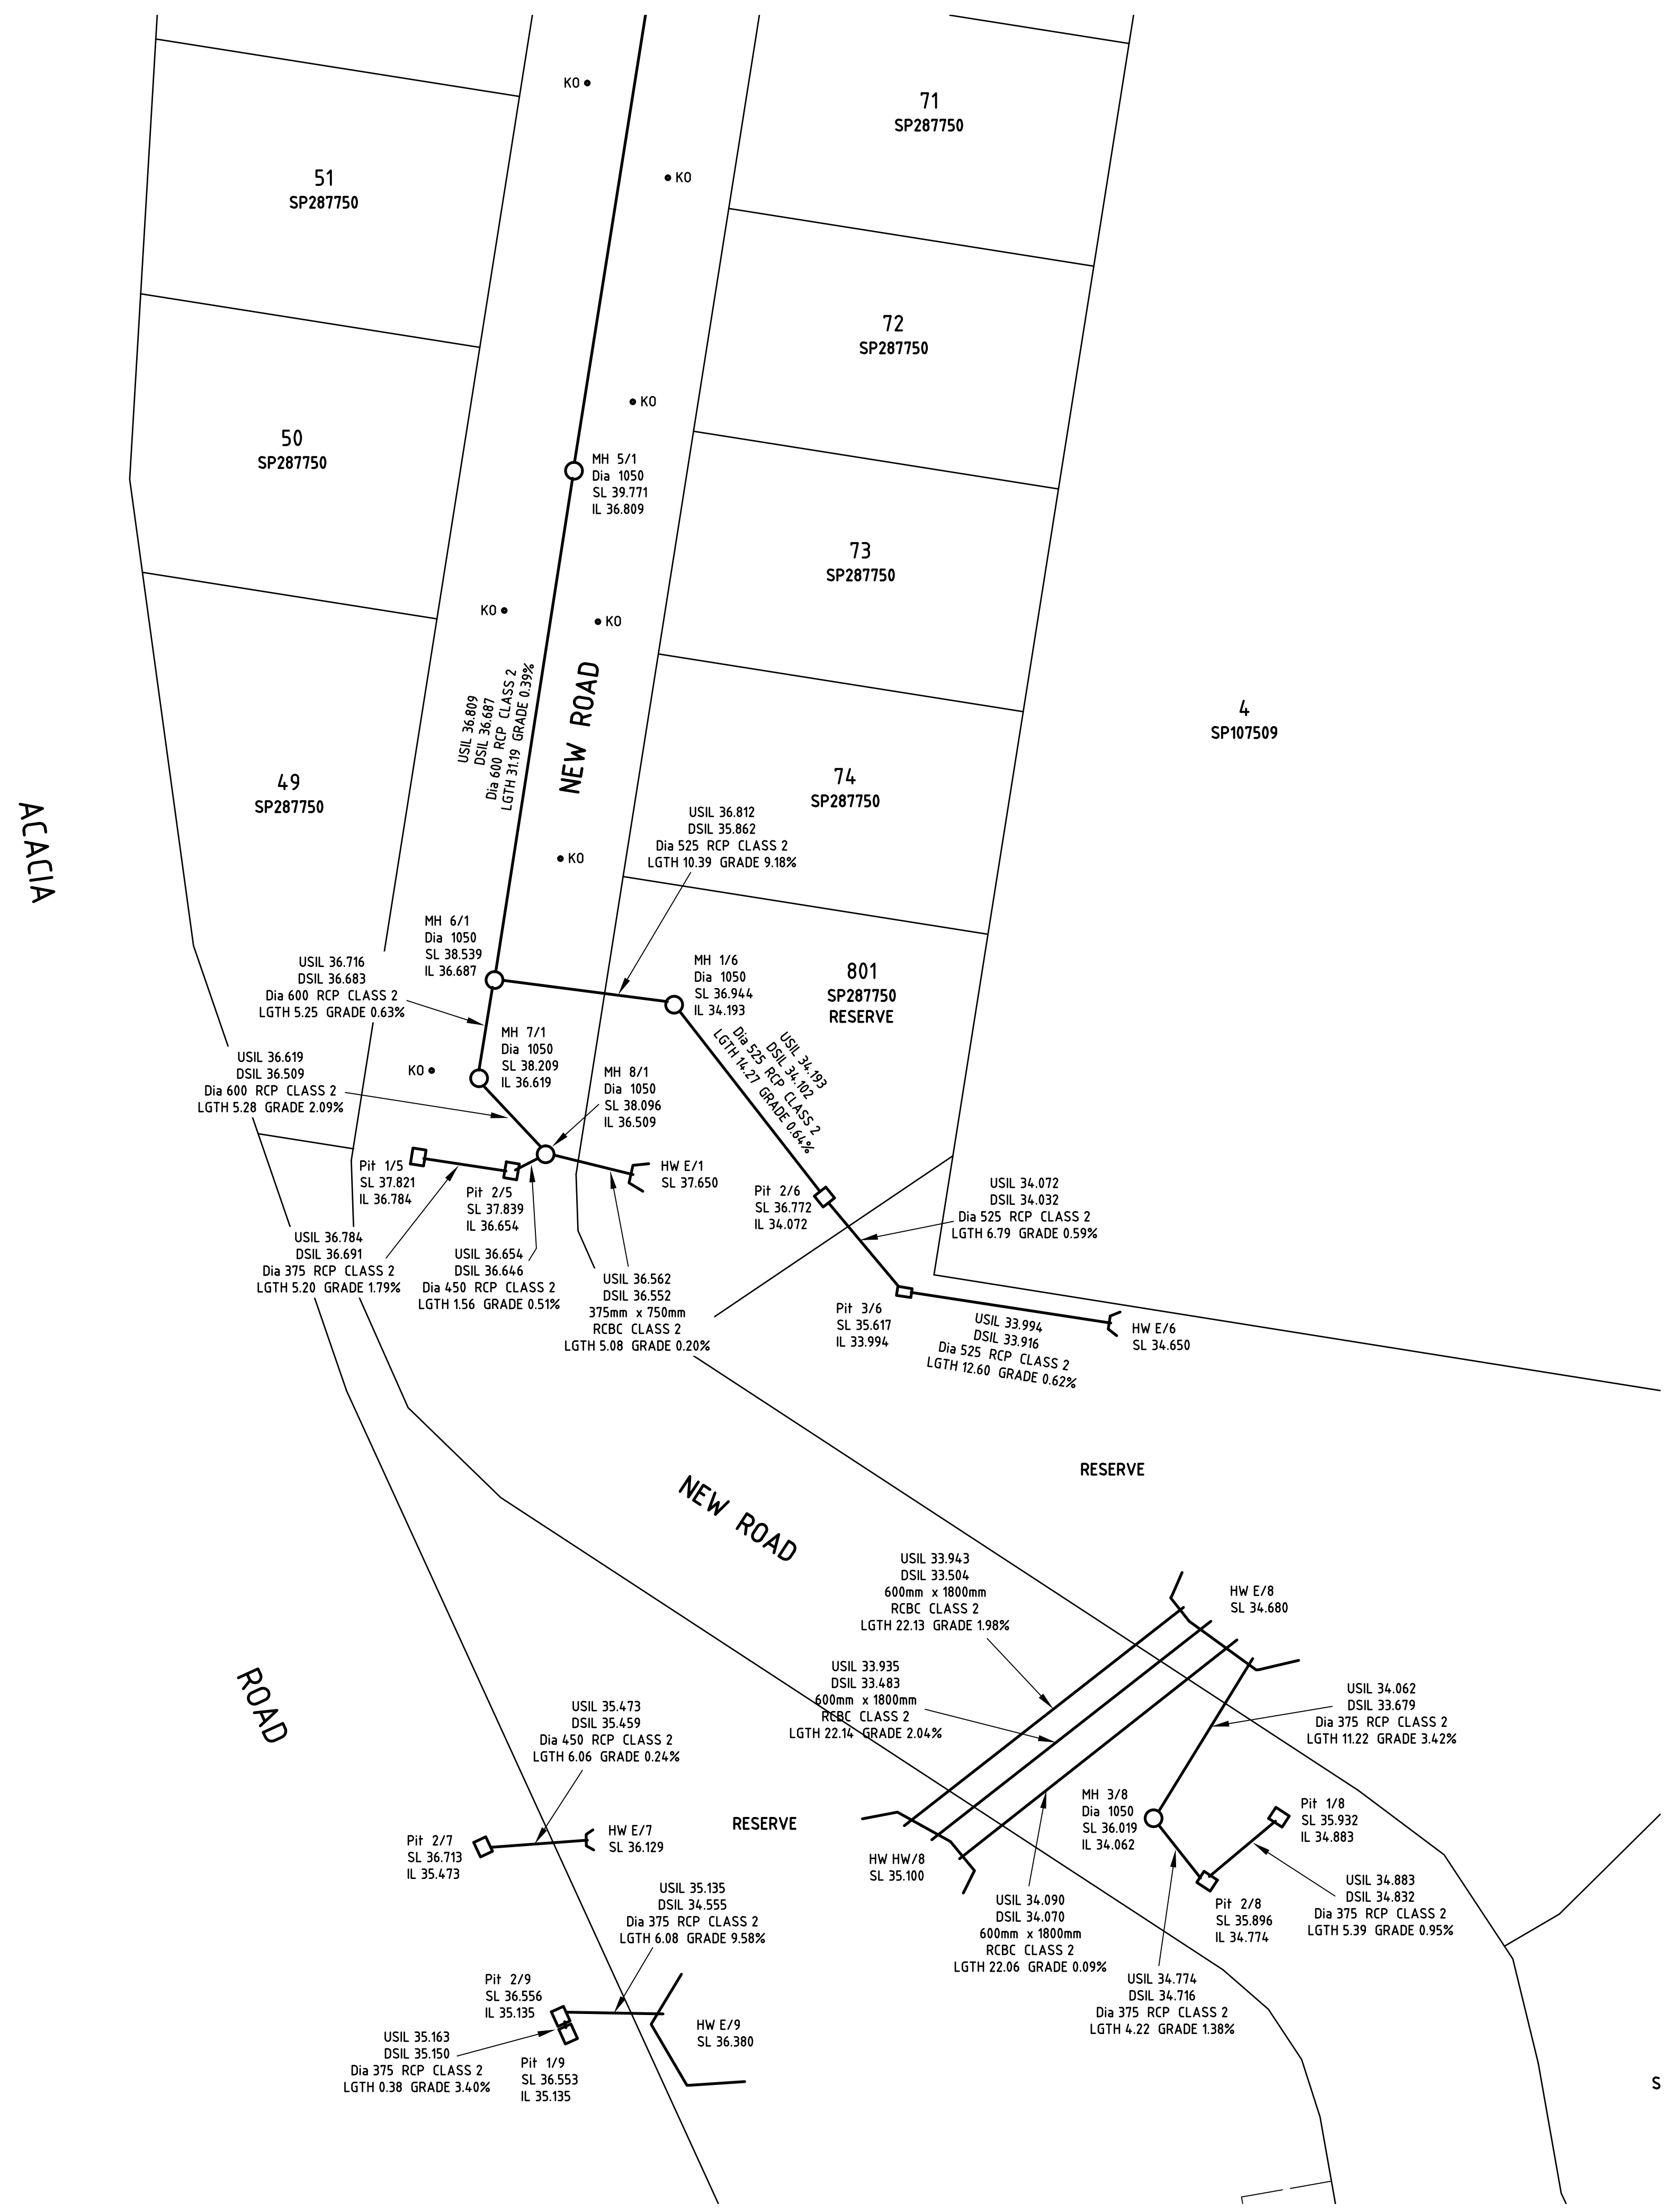

REGISTERED SURVEYOR'S CERTIFICATION

I, PAUL S. REED, hereby certify that the vertical and horizontal locations and dimensions shown on this plan are a true and correct record and were located by survey.

*Paul S. Reed*  
Registered Surveyor (Sig) Reg. Surveyor No. 1427 Date: 15/01/2021



Scale 1:250 - Lengths are in Metres.

0 2 4 6 8 10 12 14 16 18 20 22 24 26 28 30 32 34 36 38

**East Coast Surveys**  
(Aust)  
Licensed Surveyors & Subdivision Consultants

P.O. BOX 168 Cabalapa Qld 4157  
Ph (07) 3823 1029  
Email info@eastcoastsurveys.com.au

**PLAN OF AS CONSTRUCTED DRAINAGE STAGE 1 72 ACACIA ROAD KARAWATHA**

Level Datum : AHD  
PM :- RL :-  
Meridian: MGA

Client: Solido Investment Nominees 1918 Pty Ltd  
Surveyed By: MH Drawn By: QSD  
Date: 02/12/2020 Date: 15/01/2021  
Checked By: Authorized By:  
Date: Date:

Our Ref.: 4639-1 ADAC  
Rev: A January 2021  
Scale 1:250 Original Size: A1

**SHEET 1 OF 2**



REGISTERED SURVEYOR'S CERTIFICATION

I, PAUL S. REED, hereby certify that the vertical and horizontal locations and dimensions shown on this plan are a true and correct record and were located by survey.

Registered Surveyor (sig) Paul S. Reed Reg. Surveyor No. 1427 Date: 15/01/2021



Scale 1:250 - Lengths are in Metres.

2 0 2 4 6 8 10 12 14 16 18 20 22 24 26 28 30 32 34 36 38

**East Coast Surveys**  
(Aust)  
Licensed Surveyors & Subdivision Consultants

P.O. BOX 168 Capalaba Qld 4157  
Ph (07) 3823 1029  
Email info@eastcoastsurveys.com.au

**PLAN OF AS CONSTRUCTED DRAINAGE**  
STAGE 1  
72 ACACIA ROAD  
KARAWATHA

Level Datum :	AHD
PM :-	RL :-
Meridian:	MGA
Client:	Solido Investment Nominees 1918 Pty Ltd
Surveyed By:	MH
Drawn By:	QSD
Date:	02/12/2020
Date:	15/01/2021
Checked By:	
Authorized By:	
Date:	
Date:	

Our Ref.: 4639-1 ADAC  
Rev: A January 2021  
Scale 1:250 Original Size: A1