


REGISTERED SURVEYOR'S CERTIFICATION
 I, PAUL S. REED, hereby certify that the vertical and horizontal locations and dimensions shown on this plan are a true and correct record and were located by survey.
 Registered Surveyor (sig) Reg. Surveyor No. 1127 Date: 21/09/2020

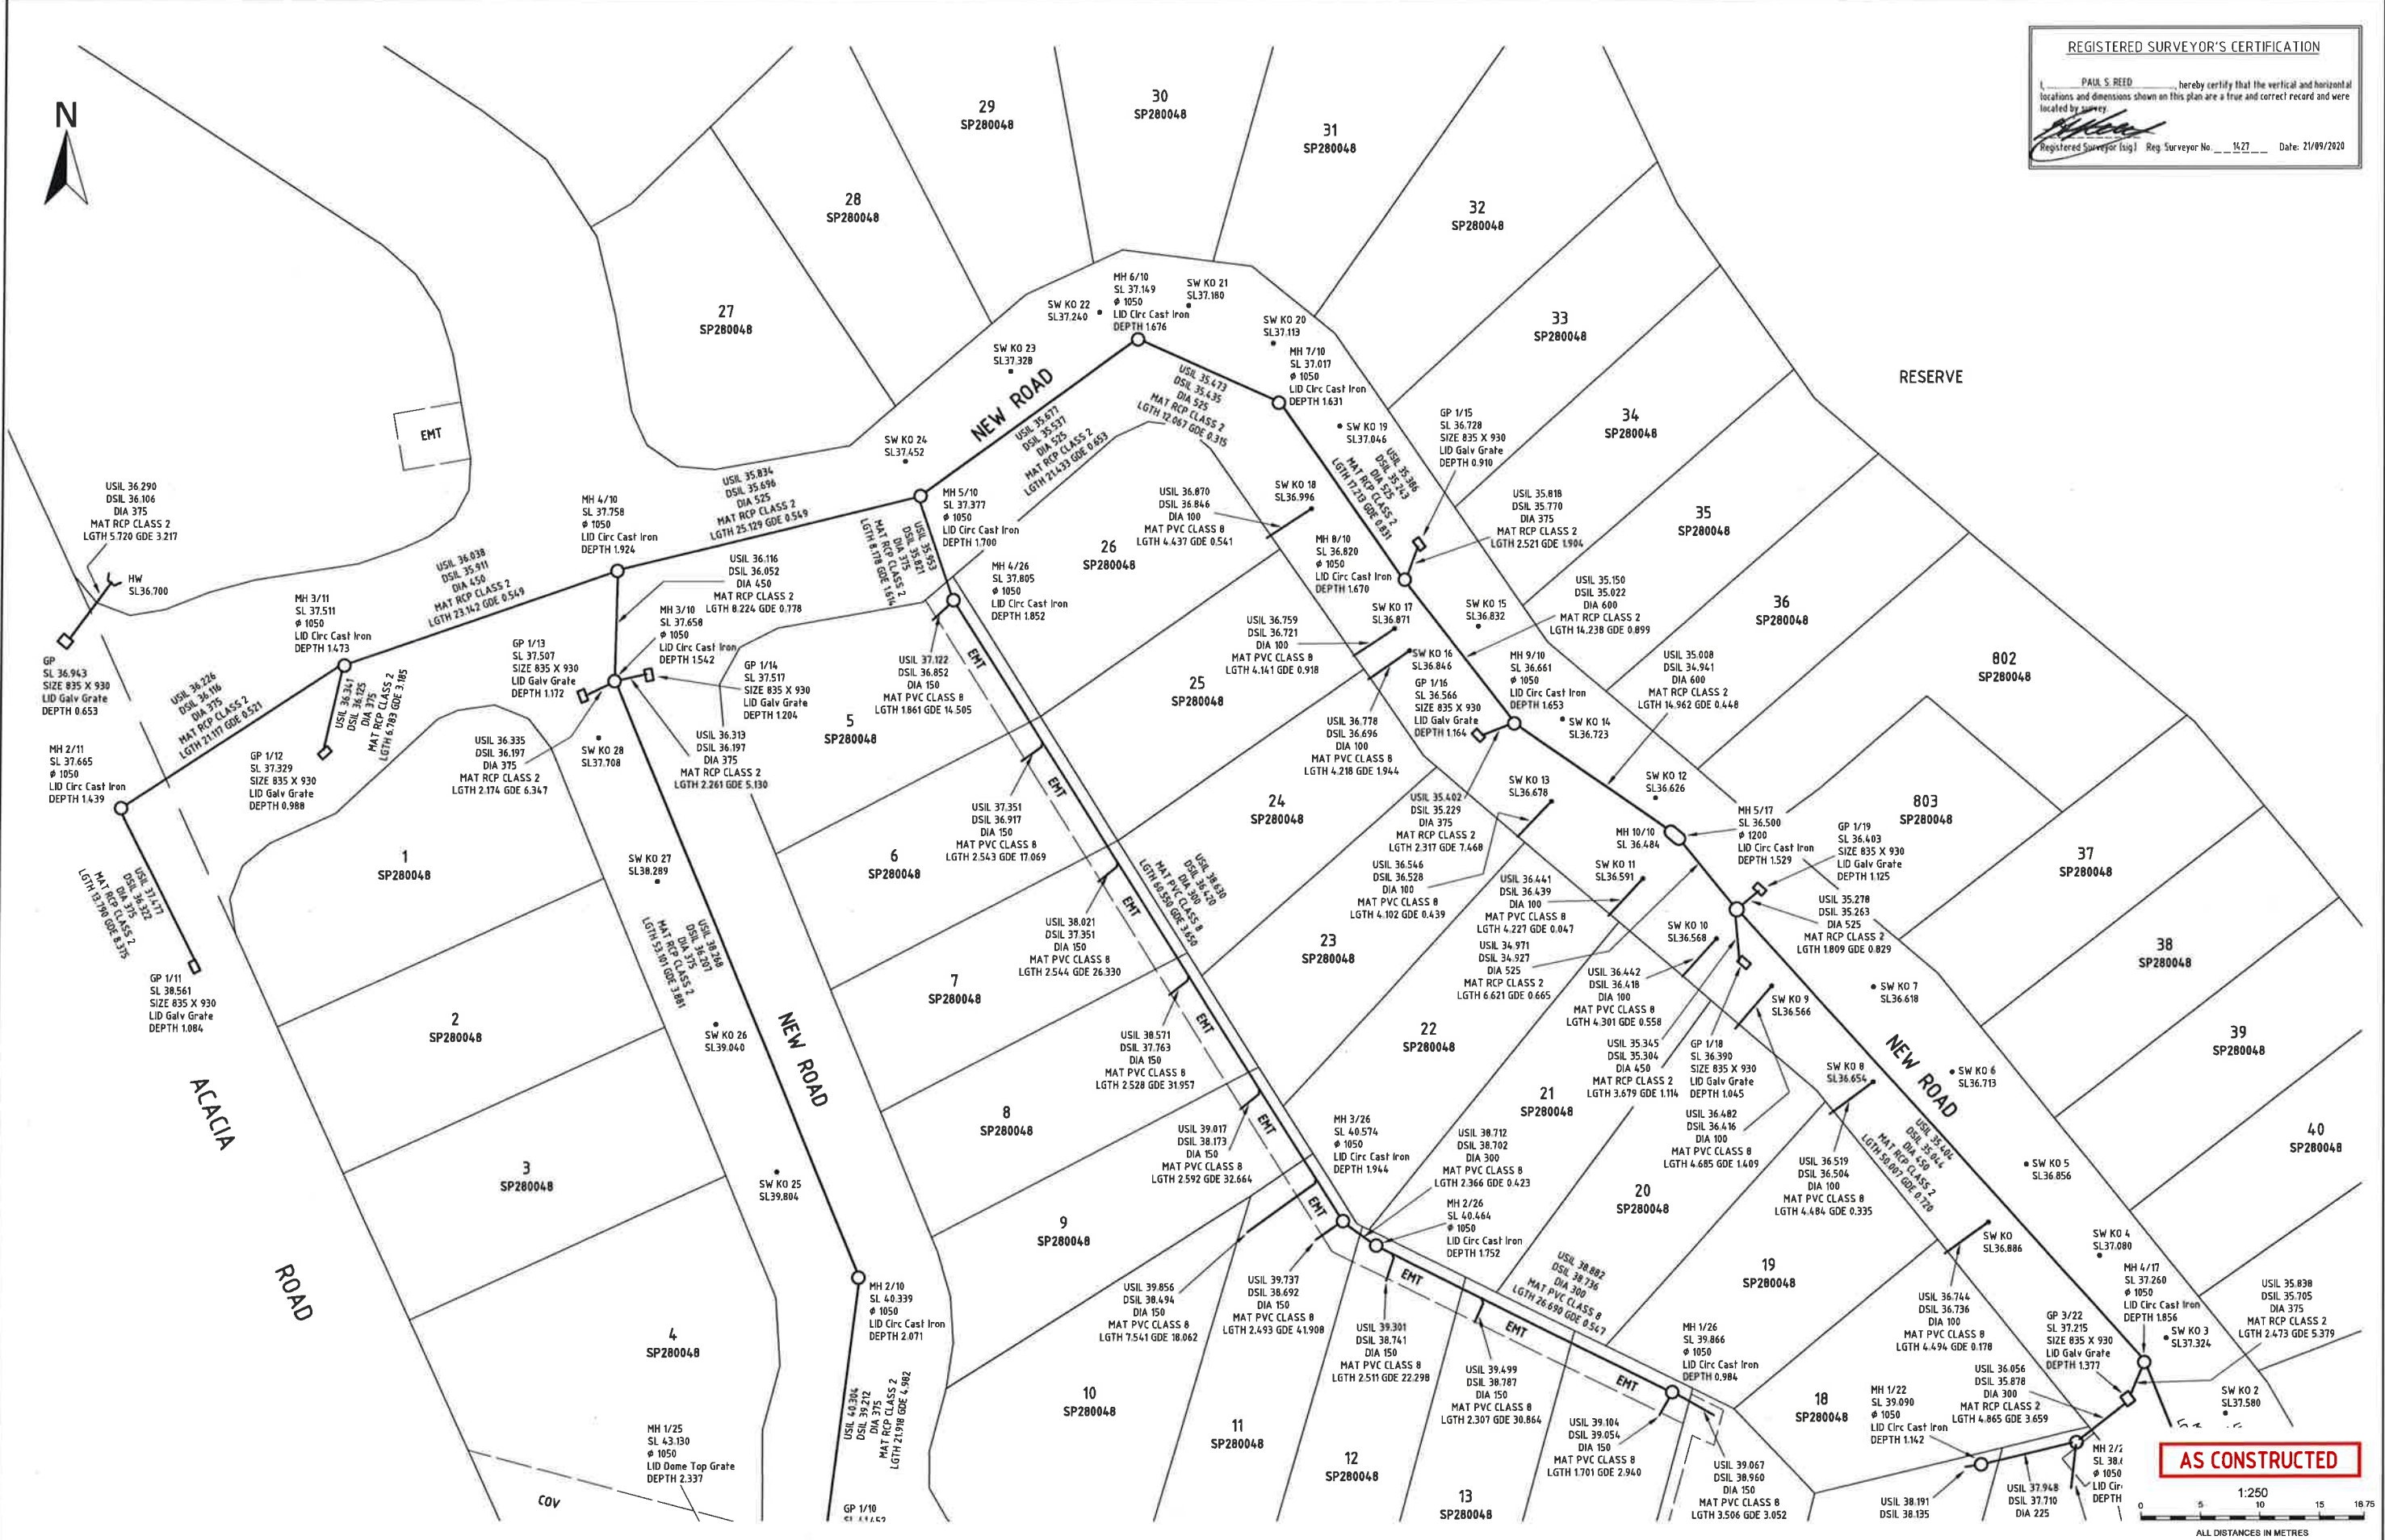

AS CONSTRUCTED

1:250
 ALL DISTANCES IN METRES

A1	1	02/10/2020	ORIGINAL ISSUE	QSD	PSR	PSR
	INDEX	DATE	REVISIONS	DRAWN	CHECKED	PASSED

DRAWN	QSD	02/10/2020
CHECKED	PSR	02/10/2020
PASSED	PSR	02/10/2020
INITIALS	DATE	





Queensland Urban Utilities
 72 ACACIA ROAD, KARAWATHA STAGE 1 & 1A
 AS CONSTRUCTED DRAINAGE

SCALE	1:250
SHEET 1	OF 2 SHEETS
DRAWING NO.	4639-1-SW

REGISTERED SURVEYOR'S CERTIFICATION

I, PAUL S REED, hereby certify that the vertical and horizontal locations and dimensions shown on this plan are a true and correct record and were located by survey.

Paul S Reed
Registered Surveyor (sig) Reg. Surveyor No. 1427 Date: 21/09/2020

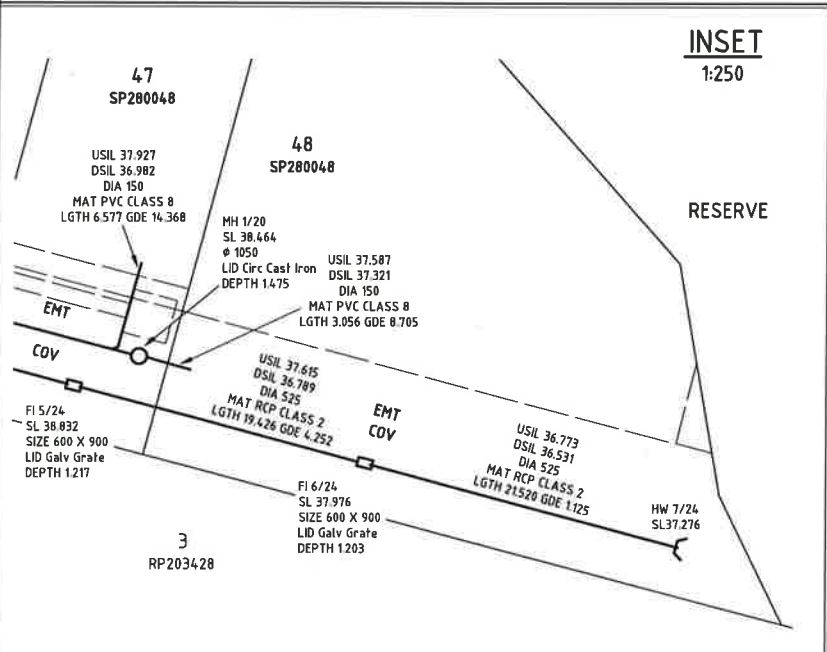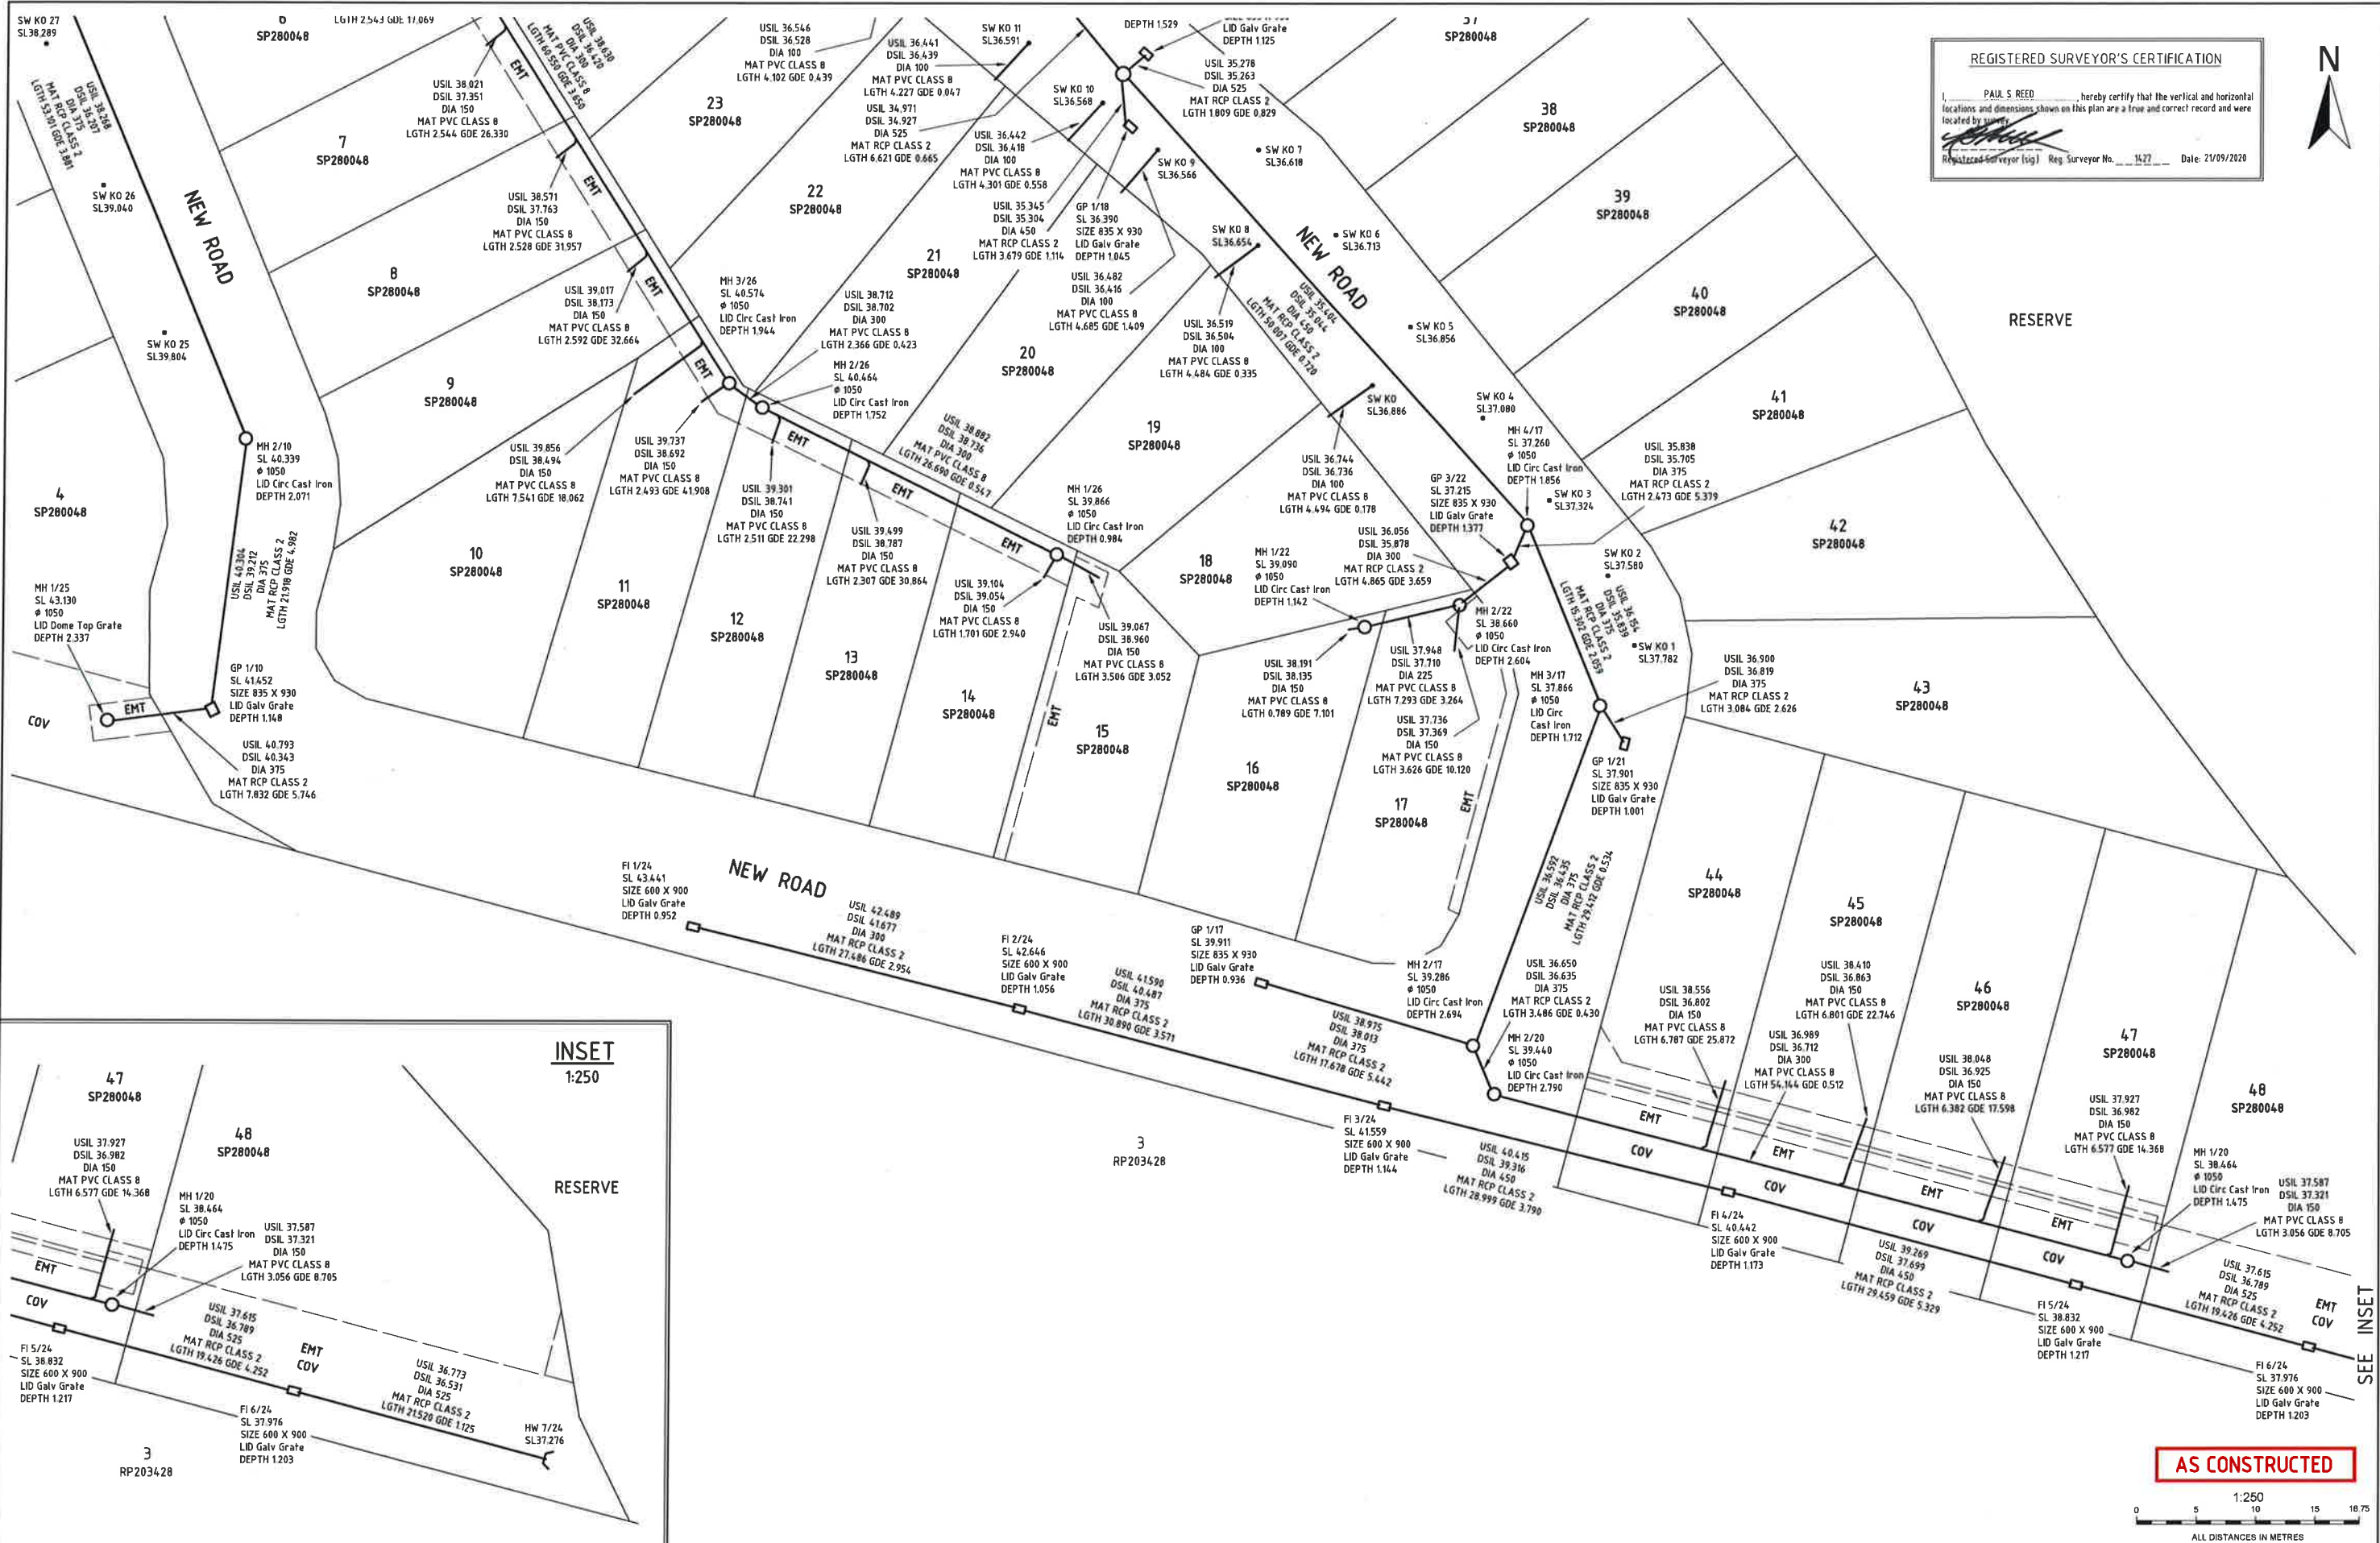

AS CONSTRUCTED

1:250
ALL DISTANCES IN METRES

A1	1	02/10/2020	ORIGINAL ISSUE	OSD	PSR	PSR
	REVISIONS			DRAWN	CHECKED	PASSED
	INDEX	DATE				

DRAWN	OSD	02/10/2020
CHECKED	PSR	02/10/2020
PASSED	PSR	02/10/2020
INITIALS	DATE	



Queensland Urban Utilities
72 ACACIA ROAD, KARAWATHA STAGE 1 & 1A
AS CONSTRUCTED DRAINAGE

SCALE 1:50
SHEET 2 OF 2 SHEETS
DRAWING NO.
4639-1-SW